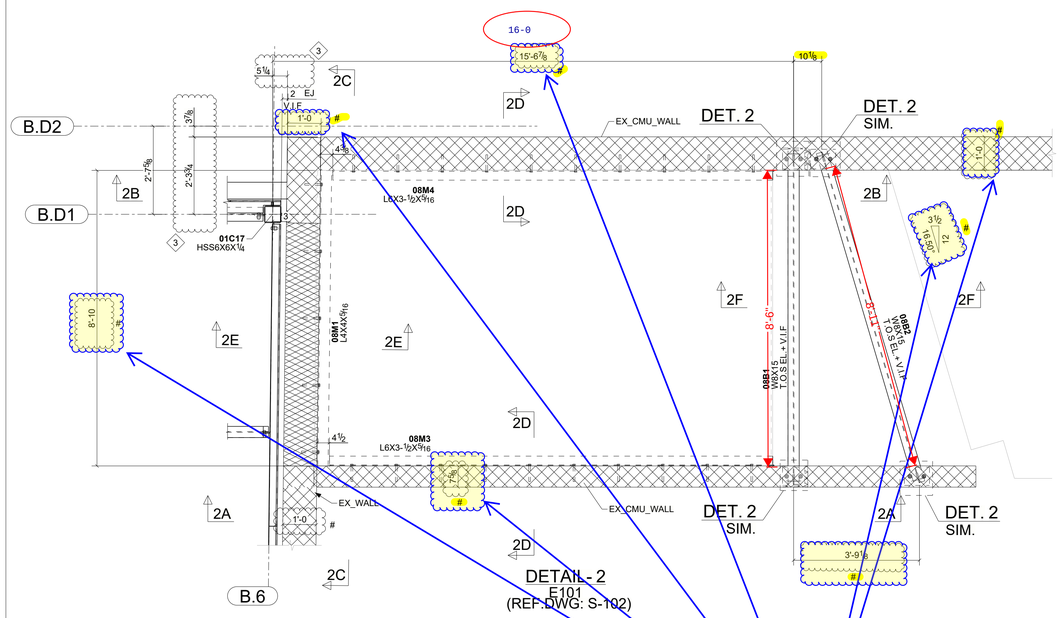

SECOND LEVEL

NOTE:

REFER EMBED PLAN EM03 & EM04 FOR EMBED RELATED QUERIES AND DETAILS FOR REFERENCE

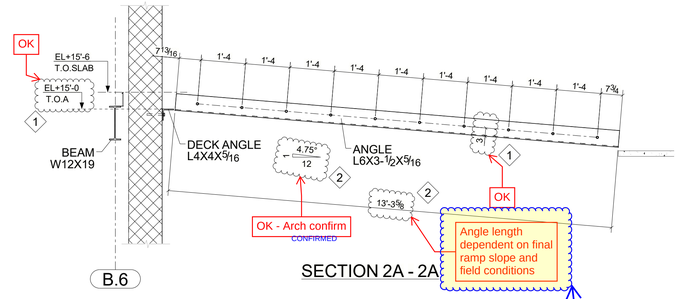

SECTION 2A - 2A

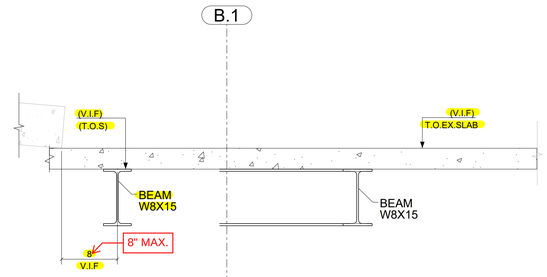

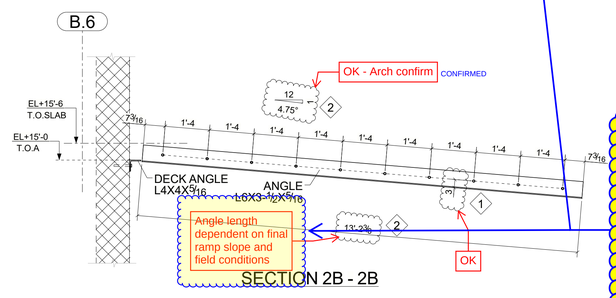

SECTION 2B - 2B

Q.2
The angle length depends on the field conditions. Therefore, we will provide the angle with an extra one foot (one end)and include a note in the drawings to cut to suit in the field. Please advise if this is acceptable, or if we need to wait for the field measurement."

Note:
We will follow typical approach for level 3. Refer to page 2 markup for reference.

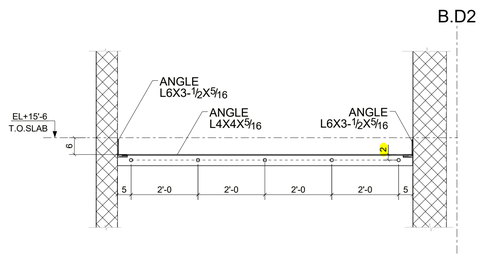

SECTION 2C - 2C

Q.1
As per the clouded notes Clouded dimensions pending GC review and comments to proceed to release associated steels for fabrication.

However if required we can provide the steels **with an extra 1'-0"(6" ether end of the angle or Beam) and include a note to cut to suit in field conditions**. Please advise if this is acceptable."

Note:
We will follow typical approach for level 3. Refer to page 2 markup for reference.

APPROVER NOTES:

1. PLEASE VERIFY AND CONFIRM THE CLOUDED ANGLE ELEVATION AND ANGLE GAGE DISTANCE FOLLOWED UNANSWERED PER PREVIOUS SUBMITTAL REVIEW.
2. PLEASE VERIFY AND ADVISE IF THE MARKED DIMENSION ARE TO BE FIELD VERIFIED ANGLE LENGTH UNANSWERED PER PREVIOUS SUBMITTAL REVIEW.
3. ARCH. TO VERIFY AND ADVISE MARKED DIMENSIONS UNANSWERED PER PREVIOUS SUBMITAL.

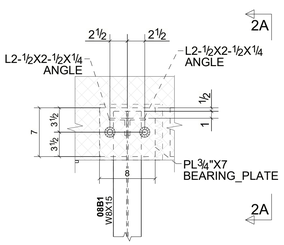

DETAIL- 2
REF.DWG: TD26/S-302

TYPICAL BEAM BEARING OVER CMU WALL DETAIL

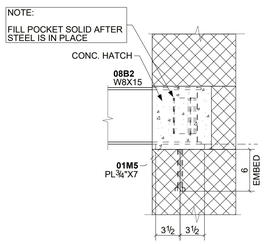

SECTION 2A - 2A

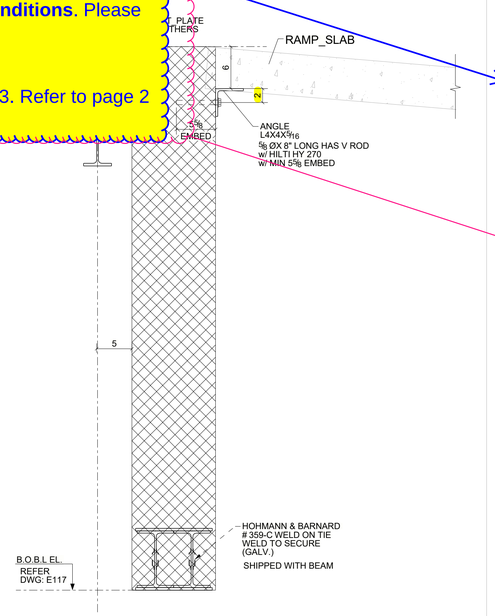

SECTION 2E - 2E
(REF.DWG: 9/S-201)

G.C. NOTE/VERIFY:

MARKED DIMENSION NEED TO BE FIELD VERIFIED FOR FRAMING PURPOSE MATCHING FIELD CONDITIONS,PENDING SURVEY INFORMATION TO PROCEED.

LEGEND:

T.O.S - TOP OF STEEL.
E.O.S. - EDGE OF SLAB.
EX_WALL - EXISTING WALL.
E.J - EXPANSION JOINT.
B.O.B.L - BOTTOM OF BEAM LINTEL.
EL. - ELEVATION.
T.O.A - TOP OF ANGLE.
T.O.SLAB - TOP OF SLAB.
GALV. - GALVANIZED
V.I.F - VERIFY IN FIELD

no the second level has a bump out 6" on each side of the wall in both location.

The 3rd level does not. Therefore the beams at the 3rd level must be 6" longer.

Project Name	Great Oak School
Fabby	-
Sketch. No.	25(Page 1 of 2)
RFI.No.	

REVISIONS

REV #	DWN BY	REVISION	DATE
A	SSV	For Approval	05/15/2025
B	MJP	For Re Approval	11/14/2025

THE INFORMATION NOTED HEREON THIS DRAWING IS THE PROPERTY OF STEEL FAB ENTERPRISES, INC. AND SHALL NOT BE USED WITHOUT WRITTEN CONSENT.

SPARTA STEEL CORPORATION
35 WOODPORT ROAD -SPARTA, NJ 07871
Phone : 973-729-3460 Fax : 973-726-0871

PROJECT OWNER: -
PROJECT DESCRIPTION: GREAT OAKS LEGACY CHARTER SCHOOL
PROJECT ADDRESS: NEWARK, NJ, 07102
CONTRACTOR: -
DRAWN BY: SSV DATE: 11/14/2025 PROJ. NO. 2510 REV # B
CHECKED BY: ASK DATE: 11/14/2025 DWG NO. E112
DWG DESCRIPTION: SECTIONS & DETAILS

RECEIVED
11/18/2025
SPARTA STEEL CORPORATION

Tekla Structures - 11/17/2025 08:07:00pm

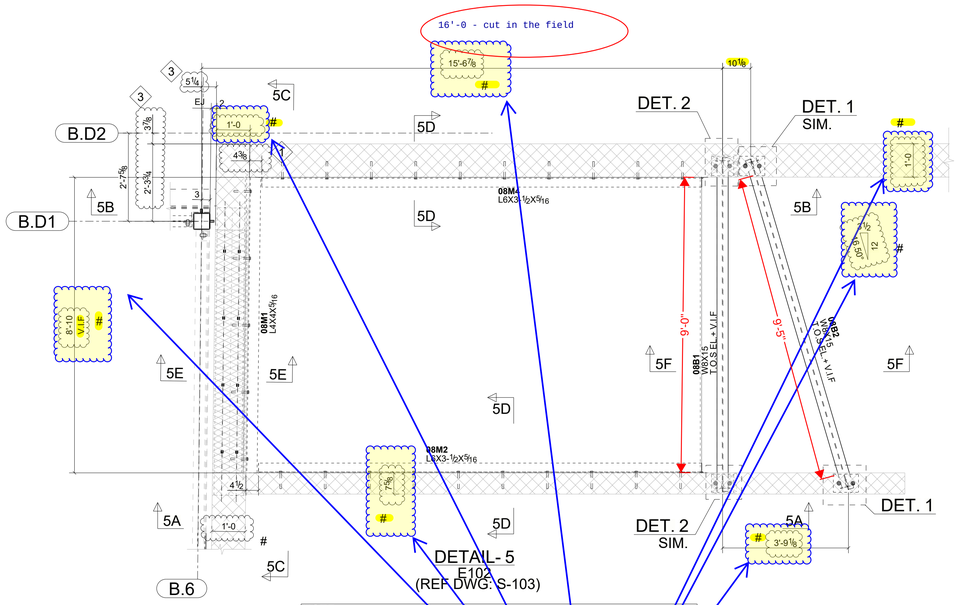

NOTE:

1. REFER EMBED PLAN EM03 & EM04 FOR EMBED RELATED QUERIES AND DETAILS FOR REFERENCE.

2. REFER EM112 FOR TYPICAL DETAILS NOT SHOWN.

THIRD LEVEL

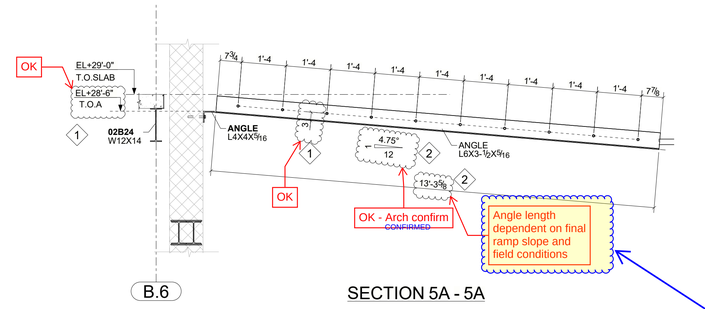

SECTION 5A - 5A

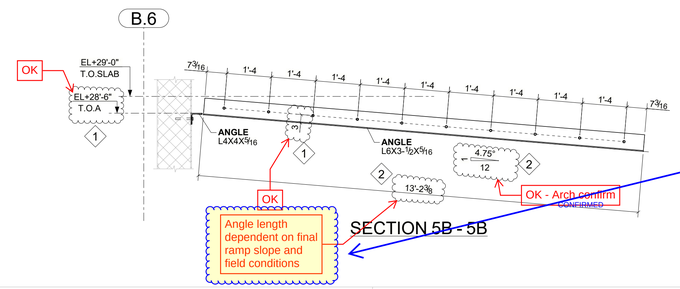

SECTION 5B - 5B

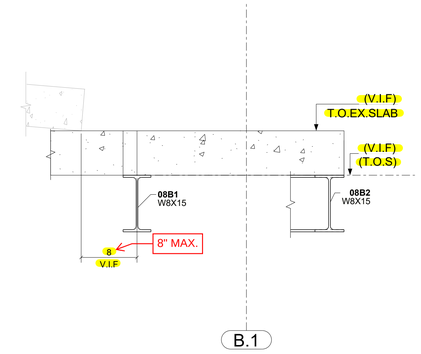

SECTION 5F - 5F
(REF.DWG: 10/S-201)

Q.4
Refer to page 1(Q.2) markup for similar question.

Q.3
Refer to page 1(Q.1) markup for similar question.

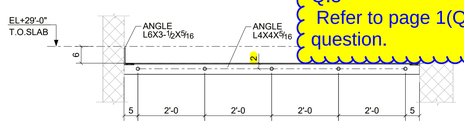

SECTION 5C - 5C

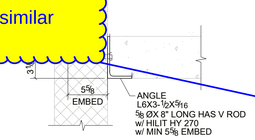

SECTION 5D - 5D
(REF.DWG: 1/S-201)

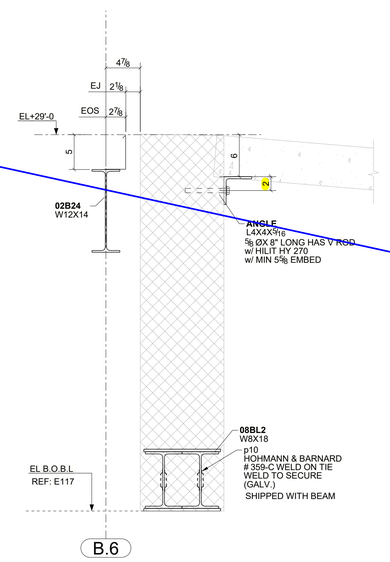

SECTION 5E - 5E
(REF.DWG: 9/S-201)

APPROVER NOTES:

1. PLEASE VERIFY AND CONFIRM THE CLOUDED ANGLE ELEVATION AND ANGLE GAGE DISTANCE FOLLOWED UNANSWERED PER PREVIOUS SUBMITTAL REVIEW.
2. PLEASE VERIFY AND ADVISE IF THE MARKED DIMENSION ARE TO BE FIELD VERIFIED ANGLE LENGTH UNANSWERED PER PREVIOUS SUBMITTAL REVIEW.
3. ARCH. TO VERIFY AND ADVISE MARKED DIMENSIONS UNANSWERED PER PREVIOUS SUBMITAL.

G.C. NOTE/VERIFY:

MARKED DIMENSION NEED TO BE FIELD VERIFIED FOR FRAMING PURPOSE MATCHING FIELD CONDITIONS,PENDING SURVEY INFORMATION TO PROCEED.

LEGEND:

T.O.S - TOP OF STEEL.

E.O.S. - EDGE OF SLAB.

EX_WALL - EXISTING WALL.

E.J - EXPANSION JOINT.

B.O.B.L - BOTTOM OF BEAM LINTEL.

EL. - ELEVATION.

T.O.A - TOP OF ANGLE.

T.O.SLAB - TOP OF SLAB.

GALV. - GALVANIZED.

V.I.F - VERIFY IN FIELD

Project Name	Great Oak School
Fabby	-
Sketch. No.	25(Page 2 of 2)
RFI.No.	

REVISIONS

REV #	DWN BY	REVISION	DATE
A	SSV	For Approval	05/15/2025
B	MJP	For Re Approval	11/14/2025

THE INFORMATION NOTED HEREON THIS DRAWING IS THE PROPERTY OF STEEL FAB ENTERPRISES, INC. AND SHALL NOT BE USED WITHOUT WRITTEN CONSENT.

SPARTA STEEL CORPORATION
35 WOODPORT ROAD -SPARTA, NJ 07871
Phone : 973-729-3460 Fax : 973-726-0871

PROJECT OWNER: -
PROJECT DESCRIPTION: GREAT OAKS LEGACY CHARTER SCHOOL
PROJECT ADDRESS: NEWARK, NJ, 07102
CONTRACTOR: -

DRAWN BY: SSV	DATE: 11/14/2025	PROJ. NO. 2510	REV #
CHECKED BY: ASK	DATE: 11/14/2025	DWG NO. E113	B

DWG DESCRIPTION: SECTIONS & DETAILS

Tekla Structures 11/17/2025 08:07:02pm

RECEIVED
11/18/2025
SPARTA STEEL CORPORATION